


TYPICAL CONDENSATE SUMP PROFILE

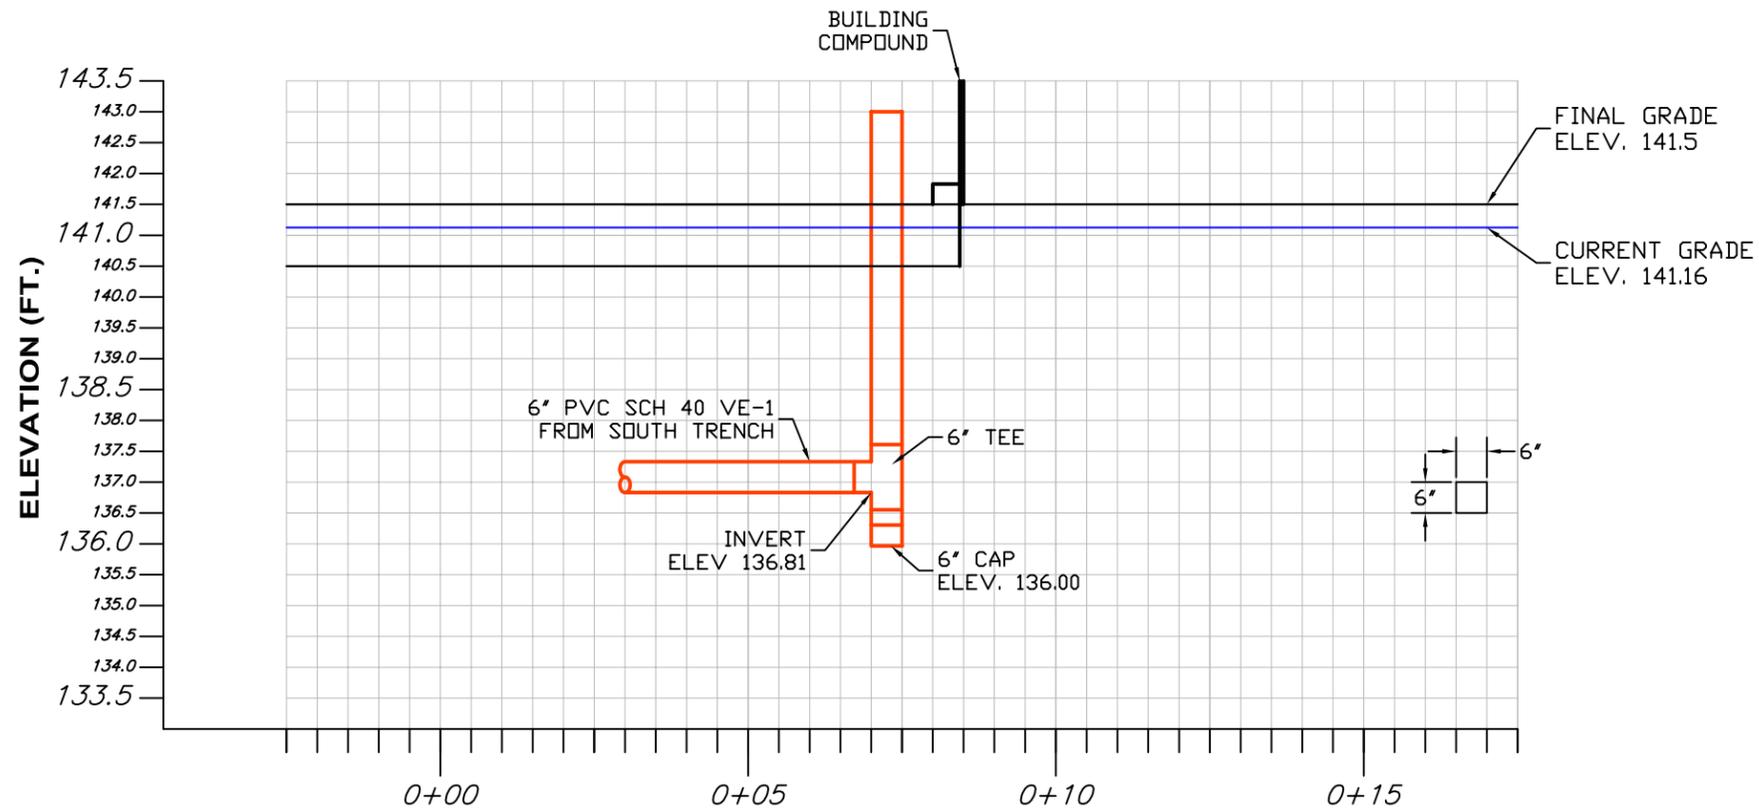

VE-1 CONDENSATE SUMP PROFILE

LEGEND:

- FINAL GRADE
- 0+10 STATION MARK (IN FEET)

NOTES:

1. THE ACTUAL CURRENT GRADE ELEVATION MAY VARY FROM THE ELEVATION SHOWN IN THIS FIGURE ACCORDING TO THE SITE CONDITIONS.
2. THE ESTIMATED ELEVATION OF FINAL GRADE IS 141.5 FT. THE TOP OF THE CONDENSATE SUMP VAULT IS ABOVE THIS ELEVATION TO ALLOW ROOM FOR SUBSURFACE FOOTERS (SEE DRAWING C-10A). GROUND WILL BE APPLIED TO FINAL GRADE ELEVATION 141.5 FT BY OTHERS.
3. THE DIMENSION OF EACH SQUARE IS 6"x6".

CONDENSATE SUMP ELEVATION PROFILES

PEMACO SUPERFUND SITE
5050 EAST SLAUSON AVENUE
MAYWOOD, CALIFORNIA

PREPARED FOR: U.S. Environmental Protection Agency Region IX San Francisco, California		PREPARED BY: T N & Associates, Inc. Engineering and Science	
SCALE: AS SHOWN	APPROVED: FINAL	DATE: 03/18/07	FIGURE
DESIGNED: JW			REV
DRAWN: DC			C-10B 5
CHECKED: JW			

AS-BUILT